


Permit No. 80-502
 Receipt No. 2564E

ON SITE SEWAGE DISPOSAL PERMIT

**This Permit expires one year from date of issue.
 Renewal for one year requires application within 30 days before expiration.**

NAME: <u>Clallam Cty. Fire District #6</u>		DATE: <u>7/17/80</u>	CHECK APPLICABLE ITEMS	
ADDRESS: <u>Star Rt. 2 Box 390</u>		PHONE: <u>374-6490</u>		Installing New System <input checked="" type="checkbox"/>
CITY: <u>Forks</u>	STATE: <u>Wash.</u>	ZIP: <u>98331</u>		Repairing Old System <input type="checkbox"/>
SPECIFIC DIRECTIONS FOR LOCATING SITE: <u>across Mora Road from 3 Rivers</u>				Expanding System <input type="checkbox"/>
<u>Resort on Lapush Road.</u>			Single Family <input type="checkbox"/>	
<u>Parcel No. - 142820430285 - 142820430300</u>			Mobile Home <input type="checkbox"/>	
<u>142820430325</u>			Commercial <input type="checkbox"/>	
LOT SIZE: <u>.466 acres</u>	NO. OF BEDROOMS: <u>-</u>		WATER SUPPLY	
			Private Well <input type="checkbox"/>	
			Surface Water <input type="checkbox"/>	
			Public Water Supply <input checked="" type="checkbox"/>	
			System Name	
			<input checked="" type="checkbox"/> Signature of Applicant <u>Diane M. Edwards, reg.</u>	

DRAW A SCALED OR DIMENSIONAL PLOT PLAN INCLUDING ALL ITEMS LISTED ON THE BACK OF THIS FORM.

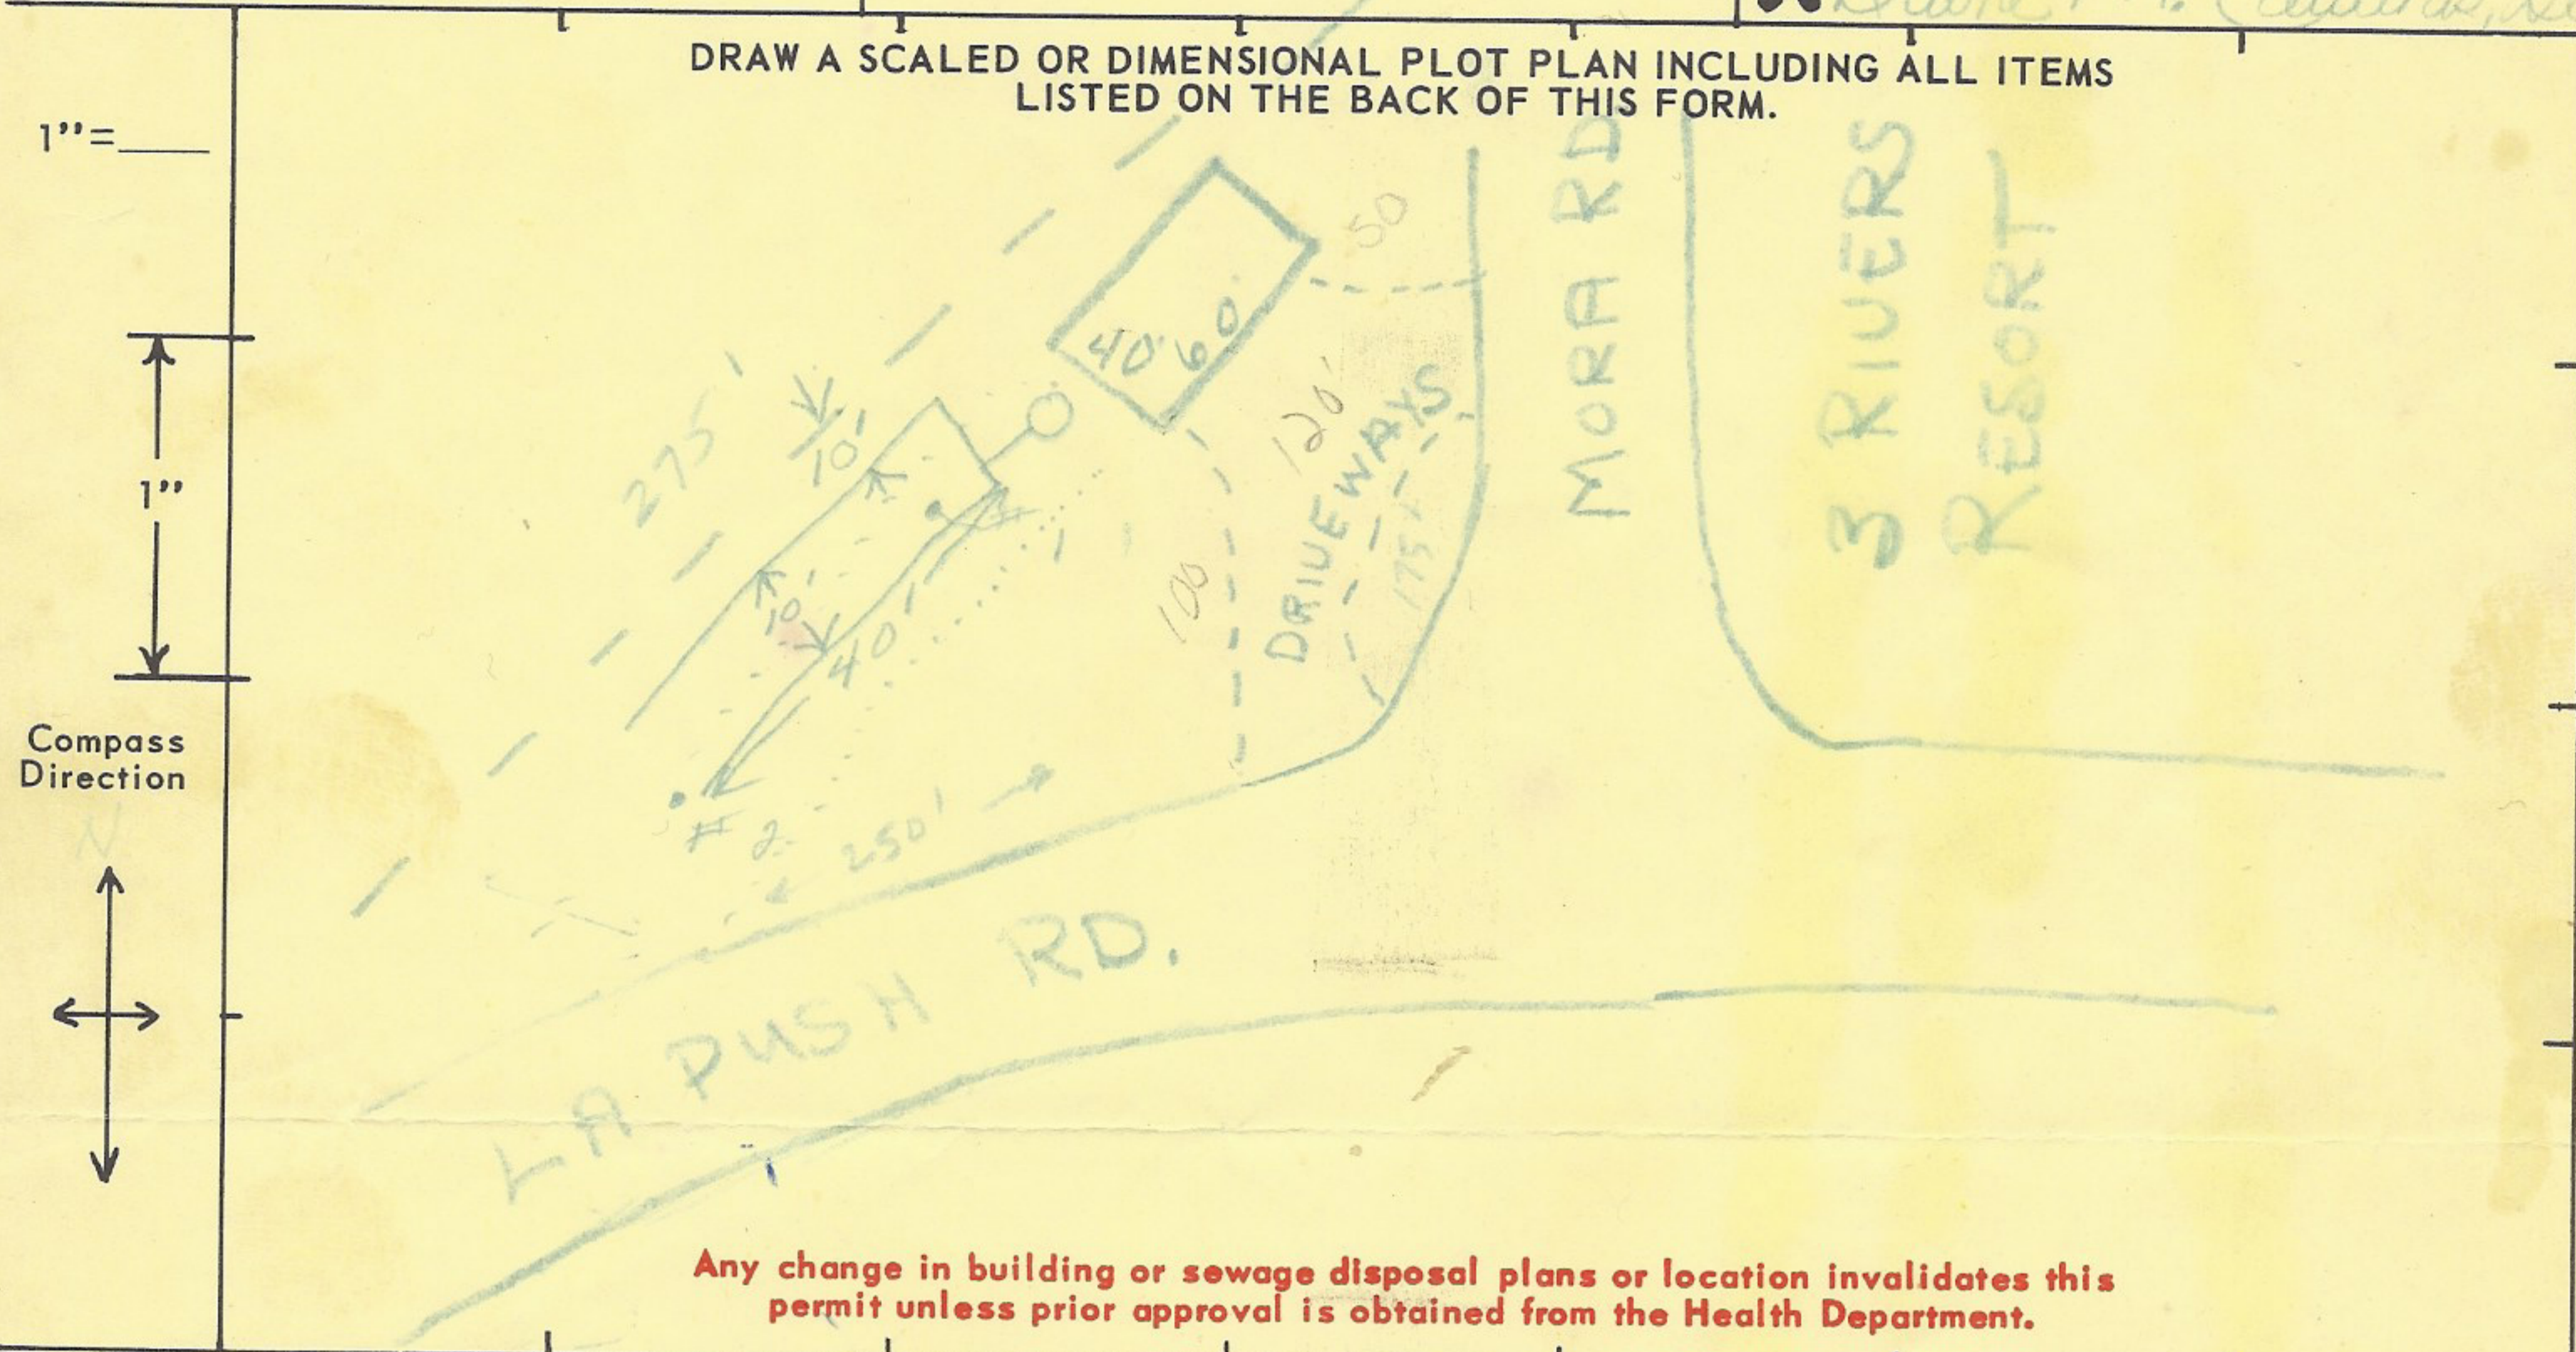

Any change in building or sewage disposal plans or location invalidates this permit unless prior approval is obtained from the Health Department.

COMMENTS: OFFICIAL USE ONLY. DO NOT WRITE BELOW THIS LINE.

Drainfield Length 80'
 Trench Width 2'
 Trench Depth 2'
 Septic Tank Size (gal.) 1000
 two compartment

Henry Hamm 9/25/80
 Approved Date
 Approved Date P F AB

SOIL LOG: Depth to Groundwater

#1. 0-24" SiCL
 24"-46" SiCL w/s+G
 46-60" SiCL w/som SiC cobbles present in both holes

#2. 0-24" SiCL
 24-54" SiCL w/increasing sand & gravel - som
 54-60" SiCL pockets of s+G